Thomas Hovel
City Planner / Zoning Administrator

Friday, November 13, 2015

RE: Minor modification request for Elan building A1 due to surveying malfunction

Tom,

Thank you for working with us on the slight setback encroachment due to D'nofrio Kottke's surveying equipment malfunction. As the building foundation and precast are already in place, we appreciate your concurrence that this be recommended as a minor modification.

To recap, building A1's southeast corner was planned and approved to be approximately 3.5 feet back from the setback line. The surveying error was approximately 5.5 feet, and now that corner encroaches into the setback line 1.89 feet.

The following information was used to determine the appropriateness of a minor modification request

- Per the attached drawing (#2 current "as built" for minor modification), there are three areas noted as encroaching into the setback 72.65 square feet. Two of the areas are the front stoop and a unit porch, and the only "building portion" is the SE corner 13.46 square feet.
- The stairway is not included as encroaching, but it is larger than previously shown and approved. JLA architects ran the impervious surface ratio and it increases 1/10th of 1%, now 58.3% from 58.2%. The SIP is approved for a maximum ISR of 60%
- The last, and hopefully most important reason to consider a minor modification is the surrounding area. The Fitchrona/Lacy intersection and corridor is a more rural environment. On the above attachment we have identified the distance between the building and the edge of the road varies between 50 and 58 feet. With regard to the 20 foot bike path easement, the 10 foot path is centered, leaving 5 feet to our property line. The new stairs are approximately 2.5 feet off the property line leaving 7.5 feet of greenspace between the paths edge and the stairs.

We request that the proposed minor modification be placed on the December 15 plan commission agenda.

Sincerely,

Craig Raddatz

Fiduciary Real Estate Development

1) 2nd AMENDMENT TO SIP

M	MASTERPLAN DATA										
DC	UNITS							PARKING			
BL	ST	1 B R	1 B R +	2 B R	2 B R +	TOTAL	BR'S	COVERED	SURFACE	TOTAL	RATIO
A 1	3	15	9	14	3	4 4	5 8	44	26	70	1.59/UNIT
B 1	3	17	13	16	3	5 2	68	5 2	3 2	8 4	1.62/UNIT
B 2	4	19	15	15	3	5 6	70	5 3	3 1	8 4	1.50/UNIT
Т.	10	5 1	3 7	4 5	9	152	196	149	89	238	1.57/UNIT
	6%	34%	24%	30%	6%						1.21/BR

PARKING NOTES:

COVERED VEHICULAR & BICYCLE PARKING COUNTS ARE MINIMUM. SURFACE PARKING COUNTS ARE MAXIMUM. COVERED BICYCLE PARKING SHALL BE PROVIDED IN THE LOWER LEVEL BY INDIVIDUAL STORAGE LOCKERS OR WALL/CEILING HOOKS ABOVE AUTOMOBILE SPACES.

LANDSCAPING NOTES:

ALL LANDSCAPING ELEMENTS SHOWN ON THIS MASTERPLAN ARE CONCEPTUAL ONLY. SEE LANDSCAPE PLANS FOR INFORMATION AND DETAILS REGARDING THE ACTUAL LANDSCAPING FOR THIS PROJECT.


EXTERIOR SITE LIGHTING:

ALL EXTERIOR LIGHTING SHALL BE ESTABLISHED, DIRECTED, AND MAINTAINED SO AS NOT TO BE CAST DIRECTLY ON PUBLIC RIGHTS-OF-WAY OR NEIGHBORING PROPERTIES-- OR BE LIGHTED IN INTENSITY OR COLORS SERIOUSLY DISTURBING TO NEIGHBORING PROPERTIES (PER CITY OF FITCHBURG ZONING CODE SECTION 22-607 (B)10.)

SEE THE FOLLOWING SHEETS FOR ADDITIONAL SITE INFORMATION:

SHEET ASP101-A1 BUILDING 'A1'
SHEET ASP101-B1 BUILDING 'B1'
SHEET ASP101-B2 BUILDING 'B2'

ZONING REQUIREMENT	DESIGN VALUE	CALCULATIONS			
SITE DENSITY	31.40 Units/Acre	152 Units / 4.84 AC. = 31.40			
BUILDING COVERAGE	29.9% of Parcel	63,035 S.F. / 210,871 S.F. = 29.9%			
FLOOR AREA RATIO	83.7% of Parcel	176,601 S.F. / 210,871 S.F. = 83.7%			
IMPERVIOUS SURFACE	58.2% of Parcel	122,676 S.F. / 210,871 S.F. = 58.2%			
LANDSCAPE AREA	41.7% of Parcel	87,894 S.F. / 210,871 S.F. = 41.7%			

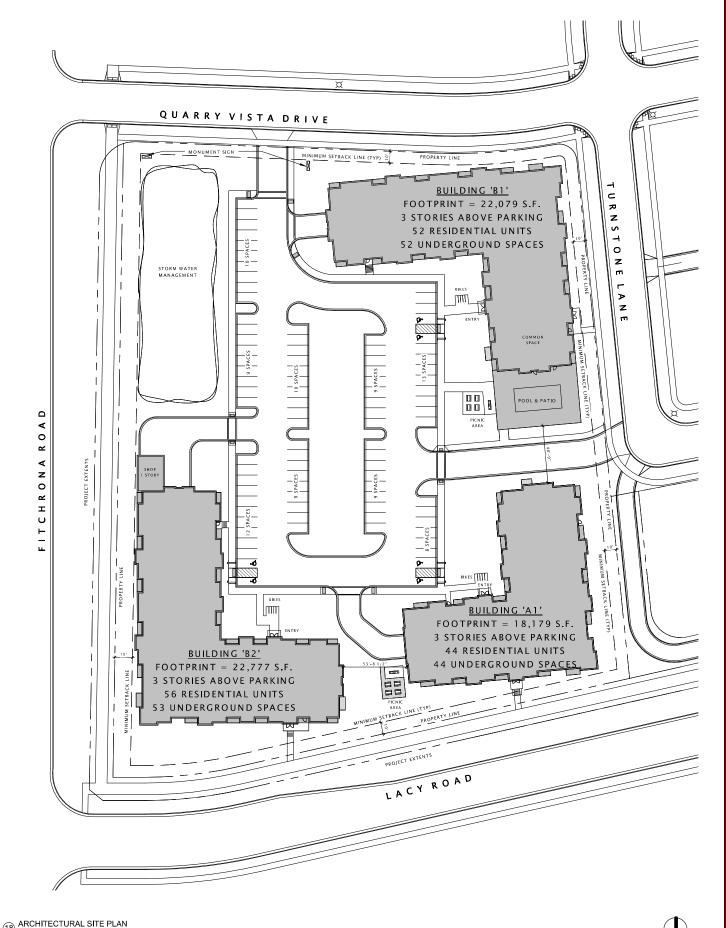





FIDUCIARY REAL
ESTATE
DEVELOPMENT, INC.

SIP - AMENDMENT



ELAN RESIDENTIAL DEVELOPMENT

PROGRESS DOCUMENTS

SEPTEMBER 9, 2015

These documents reflect progress and intent and may be subject to change, including additional detail. These are not final construction documents and should not be used for final bidding or construction-related purposes.

DATE OF ISSUANCE

HEET TITLE

ARCHITECTURAL SITE PLAN - OVERALL

SHEET NUMBER

ASP100

2) CURRENT 'AS-BUILT' FOR MINOR MODIFICATION

PARKING NOTES:

COVERED VEHICULAR & BICYCLE PARKING COUNTS ARE MINIMUM. SURFACE PARKING COUNTS ARE MAXIMUM. COVERED BICYCLE PARKING SHALL BE PROVIDED IN THE LOWER LEVEL BY INDIVIDUAL STORAGE LOCKERS OR WALL/CEILING HOOKS ABOVE AUTOMOBILE SPACES.

LANDSCAPING NOTES

ALL LANDSCAPING ELEMENTS SHOWN ON THIS MASTERPLAN ARE CONCEPTUAL ONLY. SEE LANDSCAPE PLANS FOR INFORMATION AND DETAILS REGARDING THE ACTUAL LANDSCAPING FOR THIS PROJECT.


EXTERIOR SITE LIGHTING

ALL EXTERIOR LIGHTING SHALL BE ESTABLISHED, DIRECTED, AND MAINTAINED SO AS NOT TO BE CAST DIRECTLY ON PUBLIC RIGHTS-OF-WAY OR NEIGHBORING PROPERTIES-- OR BE LIGHTED IN INTENSITY OR COLORS SERIOUSLY DISTURBING TO NEIGHBORING PROPERTIES (PER CITY OF FITCHBURG ZONING CODE SECTION 22-607 (B)10.)

SEE THE FOLLOWING SHEETS FOR ADDITIONAL SITE INFORMATION:

SHEET ASP101-A1 BUILDING 'A1'
SHEET ASP101-B1 BUILDING 'B1'
SHEET ASP101-B2 BUILDING 'B2'

ZONING REQUIREMENT	DESIGN VALUE	CALCULATIONS			
SITE DENSITY	31.40 Units/Acre	152 Units / 4.84 AC. = 31.40			
BUILDING COVERAGE	29.9% of Parcel	63,035 S.F. / 210,871 S.F. = 29.9%			
FLOOR AREA RATIO	83.7% of Parcel	176,601 S.F. / 210,871 S.F. = 83.7%			
IMPERVIOUS SURFACE	58.3% of Parcel	122,977 S.F. / 210,871 S.F. = 58.3%			
LANDSCAPE AREA	41.7% of Parcel	87,894 S.F. / 210,871 S.F. = 41.7%			

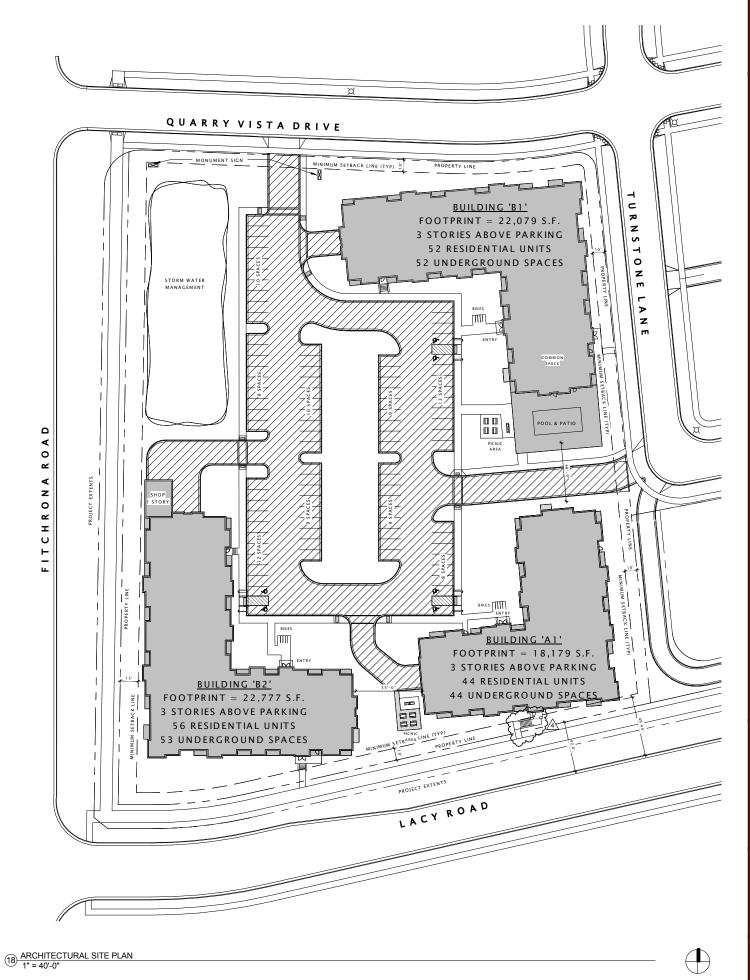



Fiduciary
REAL ESTATE DEVELOPMENT, INC.

FIDUCIARY REAL

ESTATE

DEVELOPMENT, INC.

CONSTRUCTION DOCUMENTS



ELAN RESIDENTIAL DEVELOPMENT

TE OF ISSUANCE July 31, 2015

REVISION SCHEDULE

 REVISION SCHEDULE

 Mark
 Description
 Date

 2
 Construction Bulletin 02 (ALL BLDGS.)
 09/03/2015

 4
 Construction Bulletin 04 (ALL BLDGS.)
 11/11/2015

HEET TITLE

ARCHITECTURAL SITE PLAN - OVERALL

SHEET NUMBER

ASP100

3) 3D VIEW OF PROPOSED SOUTH ENTRY STAIRS FOR MINOR MODIFICATION

